


Approved 3/13/08
 Effective 7/1/08

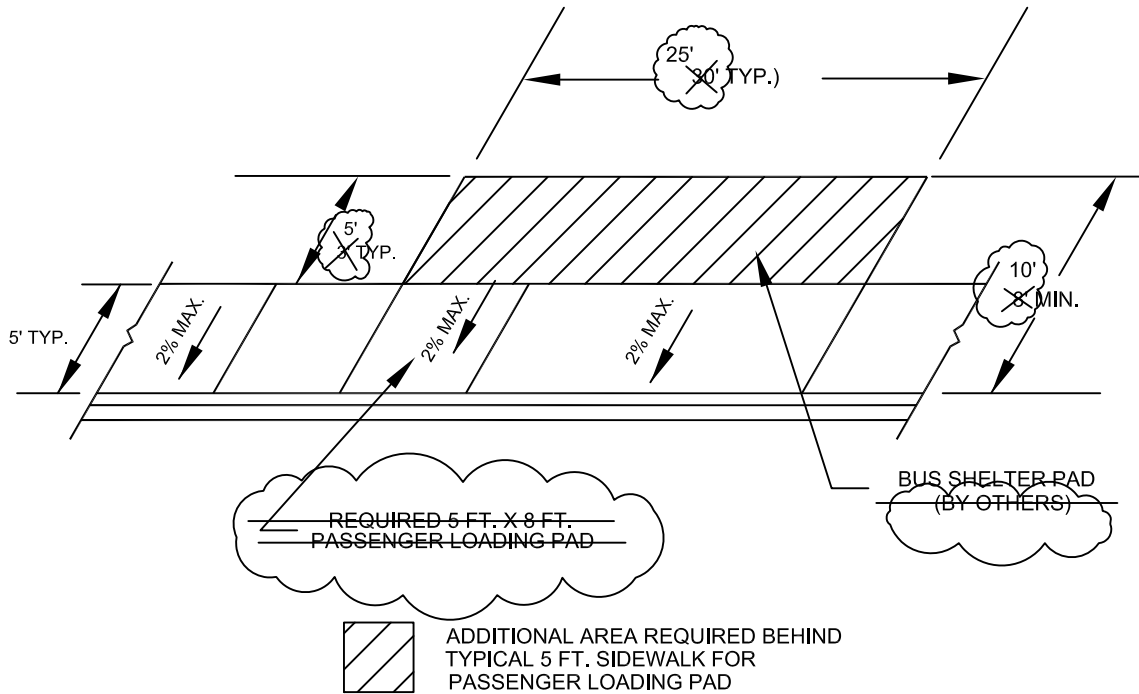

NOTES:

1. SIDEWALK RAMP MAY BE REQUIRED TO BE CONSTRUCTED IN THOSE LOCATIONS WHERE THE BUS STOP WOULD OTHERWISE BE INACCESSIBLE AS DEFINED BY THE AMERICANS WITH DISABILITIES ACT. SEE DRAWING NO. 235, SHEET 4 OF 5 FOR SIDEWALK RAMP DETAILS.
2. ADDITIONAL RIGHT-OF-WAY OR EASEMENT IS REQUIRED FOR LOADING PAD AND VARIABLE HEIGHT CURB AT BACK OF SIDEWALK RAMP AND SHALL BE DEDICATED TO THE REGIONAL TRANSPORTATION COMMISSION OF SOUTHERN NEVADA.
3. AGGREGATE BASE AND CONCRETE FOR LOADING PAD SHALL BE THE SAME AS REQUIRED FOR SIDEWALK. SEE DRAWING NO. 234.
4. LOADING PAD CONNECTION TO DETACHED SIDEWALK CONDITION SHALL BE DETERMINED BY THE ENTITIES.

SPECIFICATION REFERENCE		UNIFORM STANDARD DRAWINGS CLARK COUNTY AREA	
302	AGGREGATE BASE	TYPICAL BUS STOP PASSENGER LOADING AND SHELTER PADS	
501	CONCRETE		
502	CONCRETE STRUCTURES		
		DATE	DWG. NO. 234.2