


TRANSVERSE CUT RESTORATION

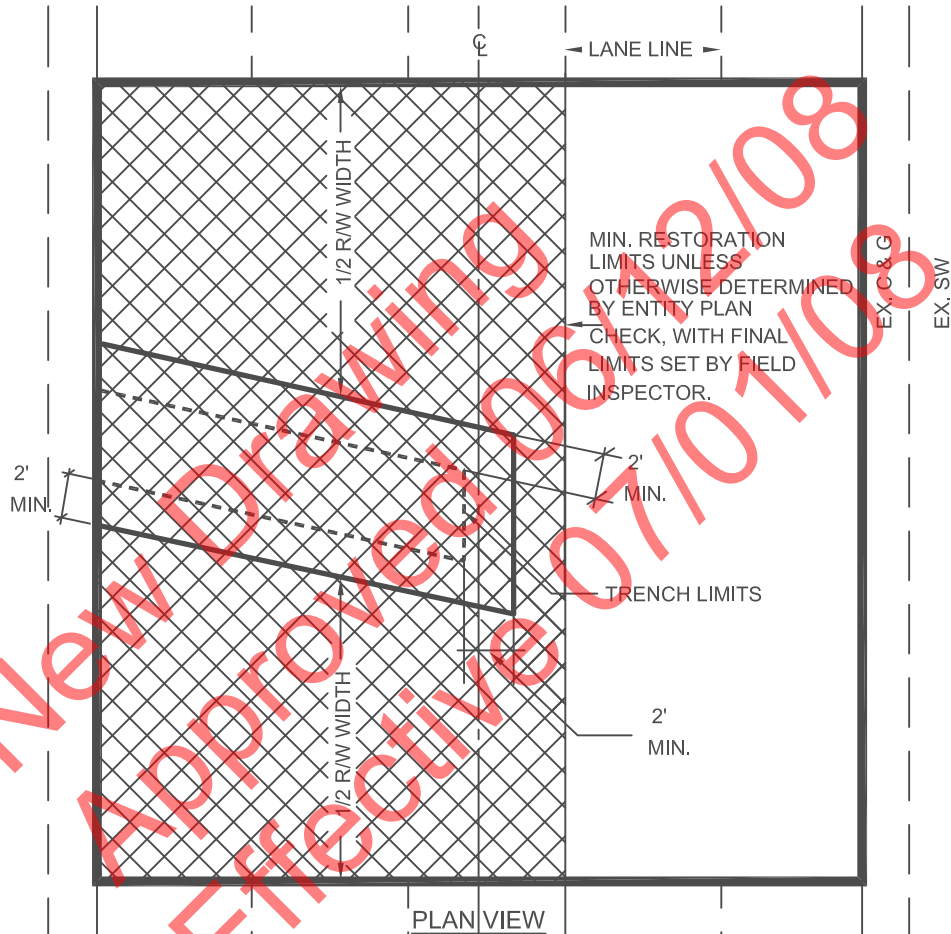

NOTES:

1. IF THERE IS MEDIAN, RESTORATION MAY BE LIMITED TO THE AREA BETWEEN C&G TO CURB OF MEDIAN.
2. IF SAWCUT LINE IS WITHIN FIVE FEET OF EDGE OF EXISTING ASPHALT CONCRETE SURFACE OR EXISTING SAWCUT LINE, MILL AND OVERLAY OR REPLACE TO THAT EDGE.
3. WHEN EXISTING PAVEMENT IS LESS 2" THICK OR LESS, PAVEMENT WITHIN THE RESTORATION AREA SHALL BE REMOVED AND REPLACED IN KIND AS REQUIRED BY THE ENTITY.
4. PAVEMENT RESTORATION AREA SAWCUT LINES SHALL NOT FALL WITHIN STREET INTERSECTION.
5. IF CUT IS WITHIN A LANE, PAVEMENT RESTORATION MUST EXTEND TO THE NEXT LANE LINE.
6. THE ENTITY'S REQUIREMENTS TAKE PRECEDENCE OVER ANY MINIMUM REQUIREMENTS SHOWN HEREON.

SPECIFICATION REFERENCE		UNIFORM STANDARD DRAWINGS CLARK COUNTY AREA	
302	AGGREGATE BASE	0 TO 5 YEARS PAVEMENT RESTORATION TRANSVERSE CUT	
401	BITUMINOUS PAVEMENT		
406	PRIME COAT		
407	FOG SEAL		
501	CONCRETE		
		DATE 6-12-08	DWG. NO. 500 AT