


LONGITUDINAL CUT RESTORATION

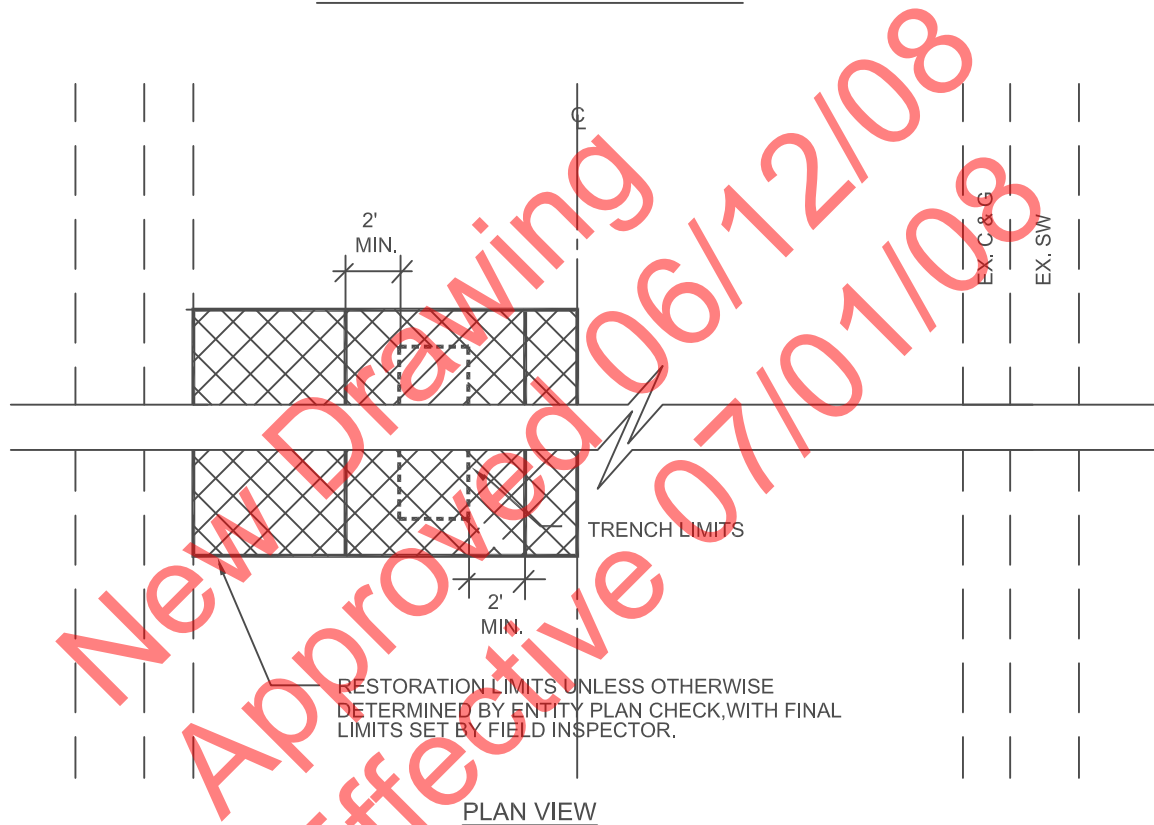

NOTES:

1. IF CUT IS WITHIN A LANE, PAVEMENT RESTORATION MUST EXTEND TO THE NEXT LANE LINE.
2. THE ENTITY'S REQUIREMENTS TAKE PRECEDENCE OVER ANY MINIMUM REQUIREMENTS SHOWN HEREON.

SPECIFICATION REFERENCE		UNIFORM STANDARD DRAWINGS CLARK COUNTY AREA	
302	AGGREGATE BASE	OVER 5 YEARS PAVEMENT RESTORATION LONGITUDINAL CUT - 60' R/W OR LESS	
401	BITUMINOUS PAVEMENT		
406	PRIME COAT		
407	FOG SEAL		
501	CONCRETE		
		DATE 6-12-08	DWG. NO. 500BL2