


MINIMUM TRENCH WIDTH IS RELATED TO DESIGN REQUIREMENTS AND SHALL BE INDICATED ON THE PLAN DRAWINGS. SEE SECTION 208-TRENCH EXCAVATION AND BACKFILL

DEPTH OF COVER IS RELATED TO DESIGN REQUIREMENTS AND SHALL BE INDICATED ON THE PLAN DRAWINGS. SEE SECTION 208-TRENCH EXCAVATION AND BACKFILL

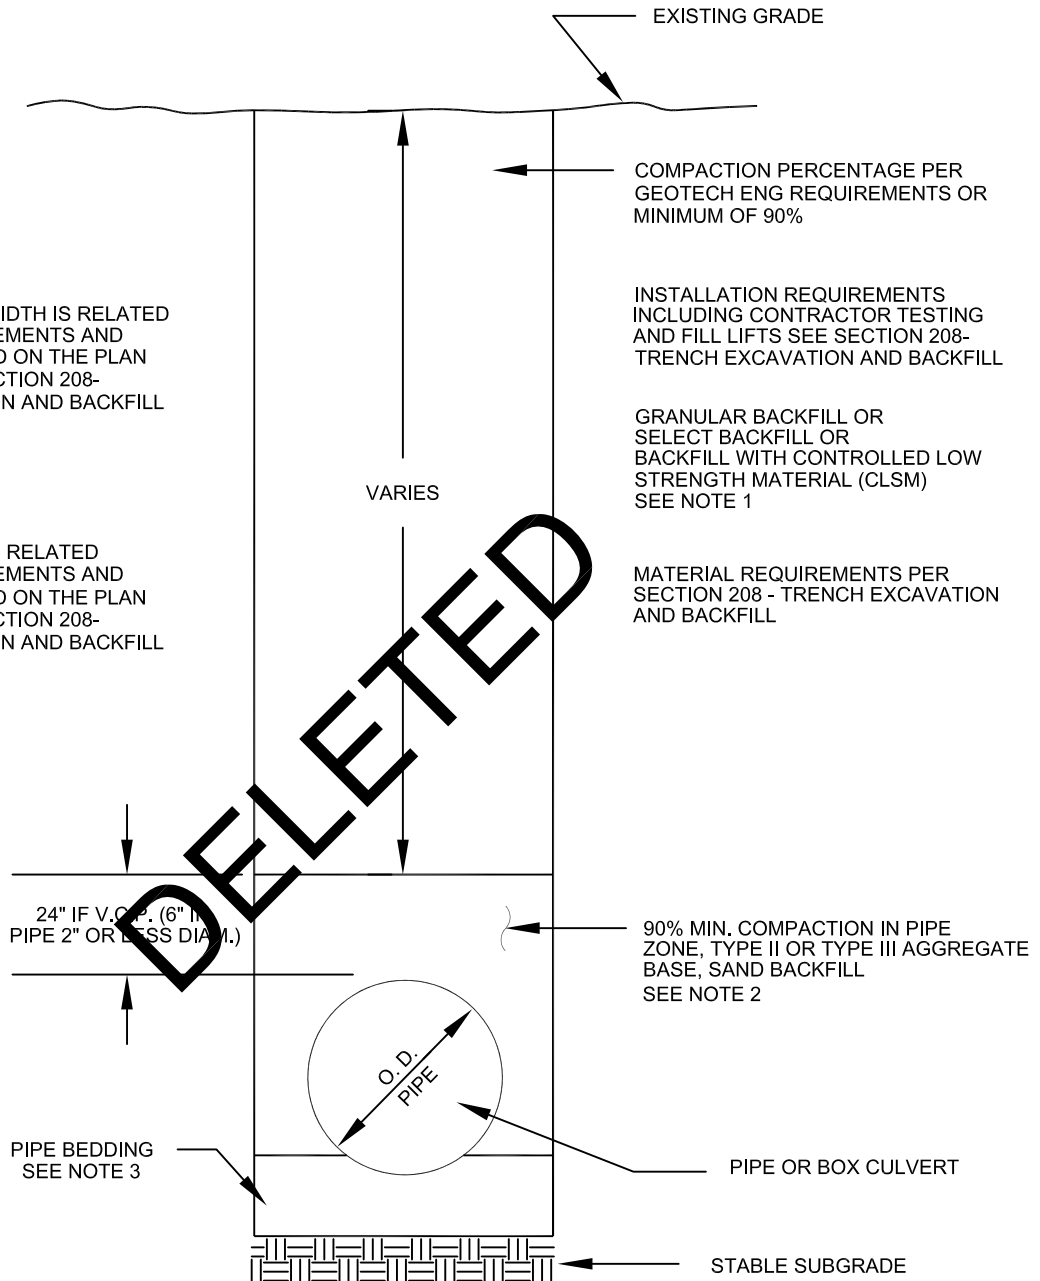

**NOTES:**

1. NO STONES OR LUMPS GREATER THAN 3" PERMITTED IN TRENCH 2' OR LESS IN WIDTH.
2. TRENCH WIDTH, BEDDING, SUBGRADE AND PIPE ZONE REQUIREMENTS FOR UTILITY INSTALLATIONS SHALL CONFORM TO THE RESPECTIVE AGENCY REQUIREMENTS.
3. CRUSHED ROCK MAY BE USED FOR PIPE BEDDING ONLY IF MATERIAL USE HAS BEEN SPECIFICALLY APPROVED BY THE GOVERNING AGENCY. SEE STANDARD DRAWING NO. 505 FOR PIPE BEDDING METHODS.
4. LAS VEGAS VALLEY WATER DISTRICT REQUIRES PIPE BEDDING AND BACKFILL WITHIN THE PIPE ZONE TO BE OF THE SAME MATERIAL.
5. A ONE INCH MAXIMUM LEVELING COURSE IS PERMITTED WHEN APPROVED BY THE ENGINEER.

SPECIFICATION REFERENCE		UNIFORM STANDARD DRAWINGS CLARK COUNTY AREA					
208	TRENCH EXCAVATION & BACKFILL						
302	AGGREGATE BASE COURSES	METHOD B FOR RIGID AND FLEXIBLE PIPE TRENCH BACKFILL - UNPAVED AREAS AND AREAS OUTSIDE EXISTING OR FUTURE PROPOSED STREET RIGHT-OF-WAY					
		DATE	11-9-06	DWG. NO.	502	PAGE	