


RESTORATION LIMITS UNLESS OTHERWISE DETERMINED BY ENTITY PLAN CHECK, WITH FINAL LIMITS BY FIELD INSPECTOR.

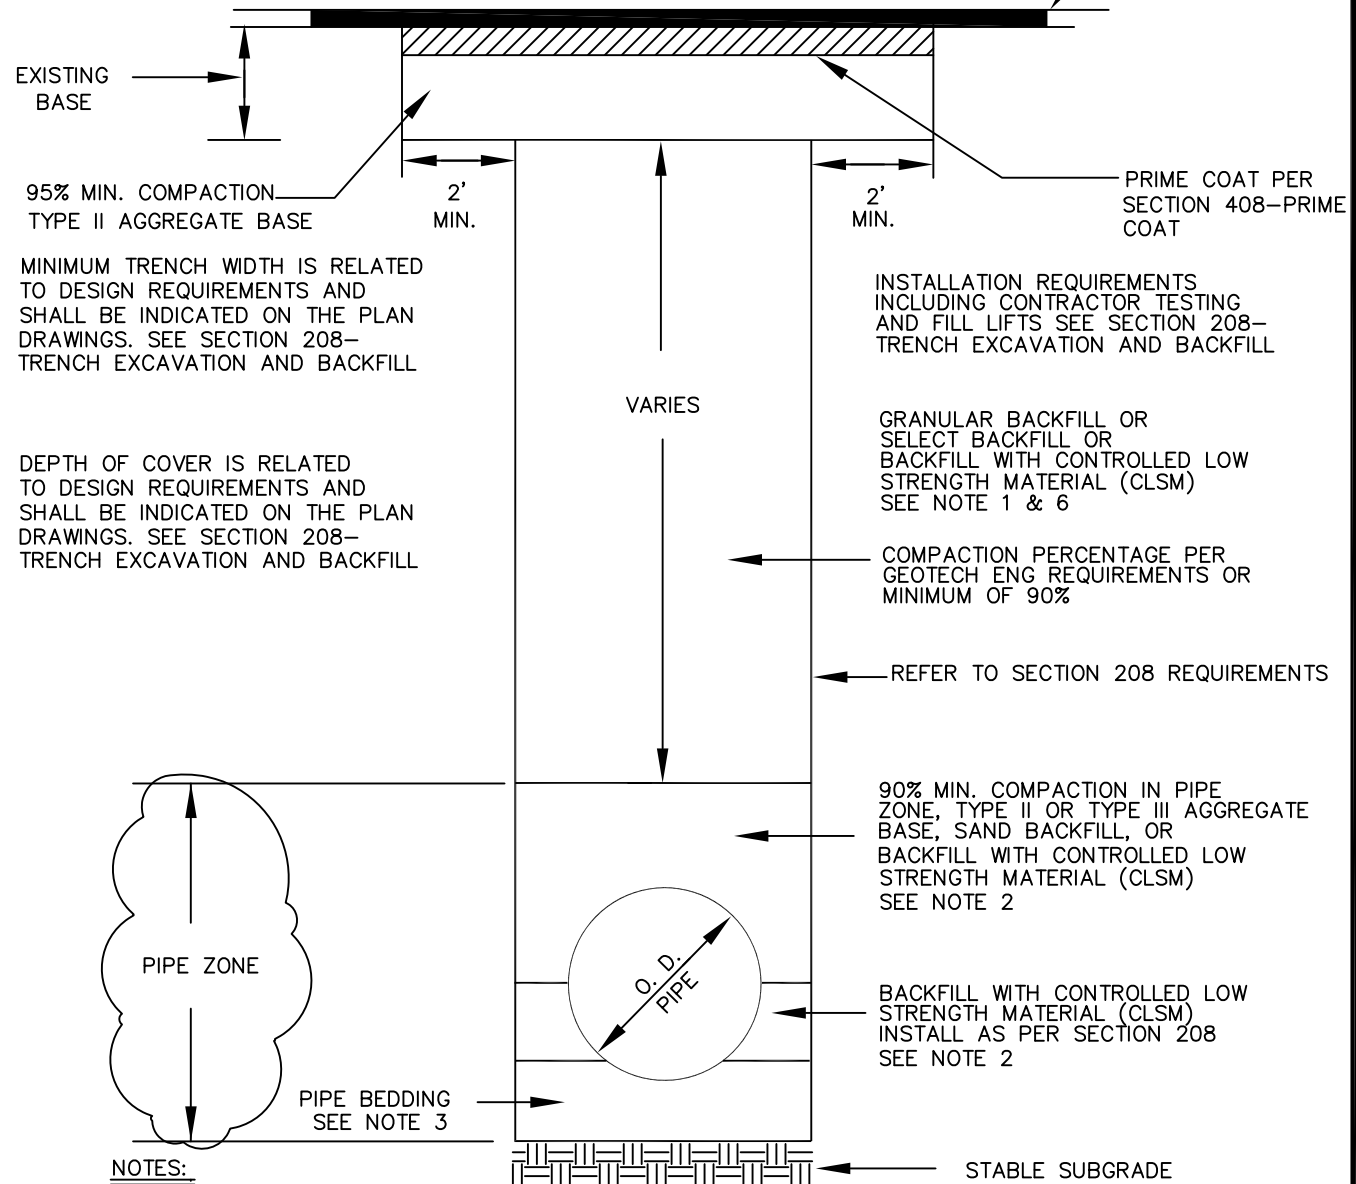

NOTES:

1. NO STONES OR LUMPS GREATER THAN 3" PERMITTED IN TRENCH 2' OR LESS IN WIDTH.
2. TRENCH WIDTH, BEDDING, SUBGRADE AND PIPE ZONE REQUIREMENTS FOR UTILITY INSTALLATIONS SHALL CONFORM TO THE RESPECTIVE ENTITY REQUIREMENTS.
3. CRUSHED ROCK MAY BE USED FOR PIPE BEDDING ONLY IF MATERIAL USE HAS BEEN SPECIFICALLY APPROVED BY THE GOVERNING AGENCY. SEE STANDARD DRAWING NO. 505 FOR PIPE BEDDING METHODS.
4. LAS VEGAS VALLEY WATER DISTRICT REQUIRES PIPE BEDDING AND BACKFILL WITHIN THE PIPE ZONE TO BE OF THE SAME MATERIAL.
5. A ONE INCH MAXIMUM LEVELING COURSE IS PERMITTED WHEN APPROVED BY THE ENGINEER.
6. CONTROLLED LOW STRENGTH MATERIALS (CLSM) SHALL BE USED IN THE UPPER 12" WITH RIGHT-OF-WAYS 30' 60' FEET OR GREATER.

SPECIFICATION REFERENCE		UNIFORM STANDARD DRAWINGS CLARK COUNTY AREA		
208	TRENCH EXCAVATION & BACKFILL	METHOD A B FOR RIGID PIPE TRENCH BACKFILL - PAVED AREAS AND AREAS OUTSIDE EXISTING OR FUTURE PROPOSED STREET RIGHT OF WAY		
302	AGGREGATE BASE COURSES			
		DATE	DWG. NO. 503AB	PAGE