


RESTORATION LIMITS TO BE DETERMINED BY ENTITY PLAN CHECK, WITH FINAL LIMITS SET BY FIELD INSPECTOR.

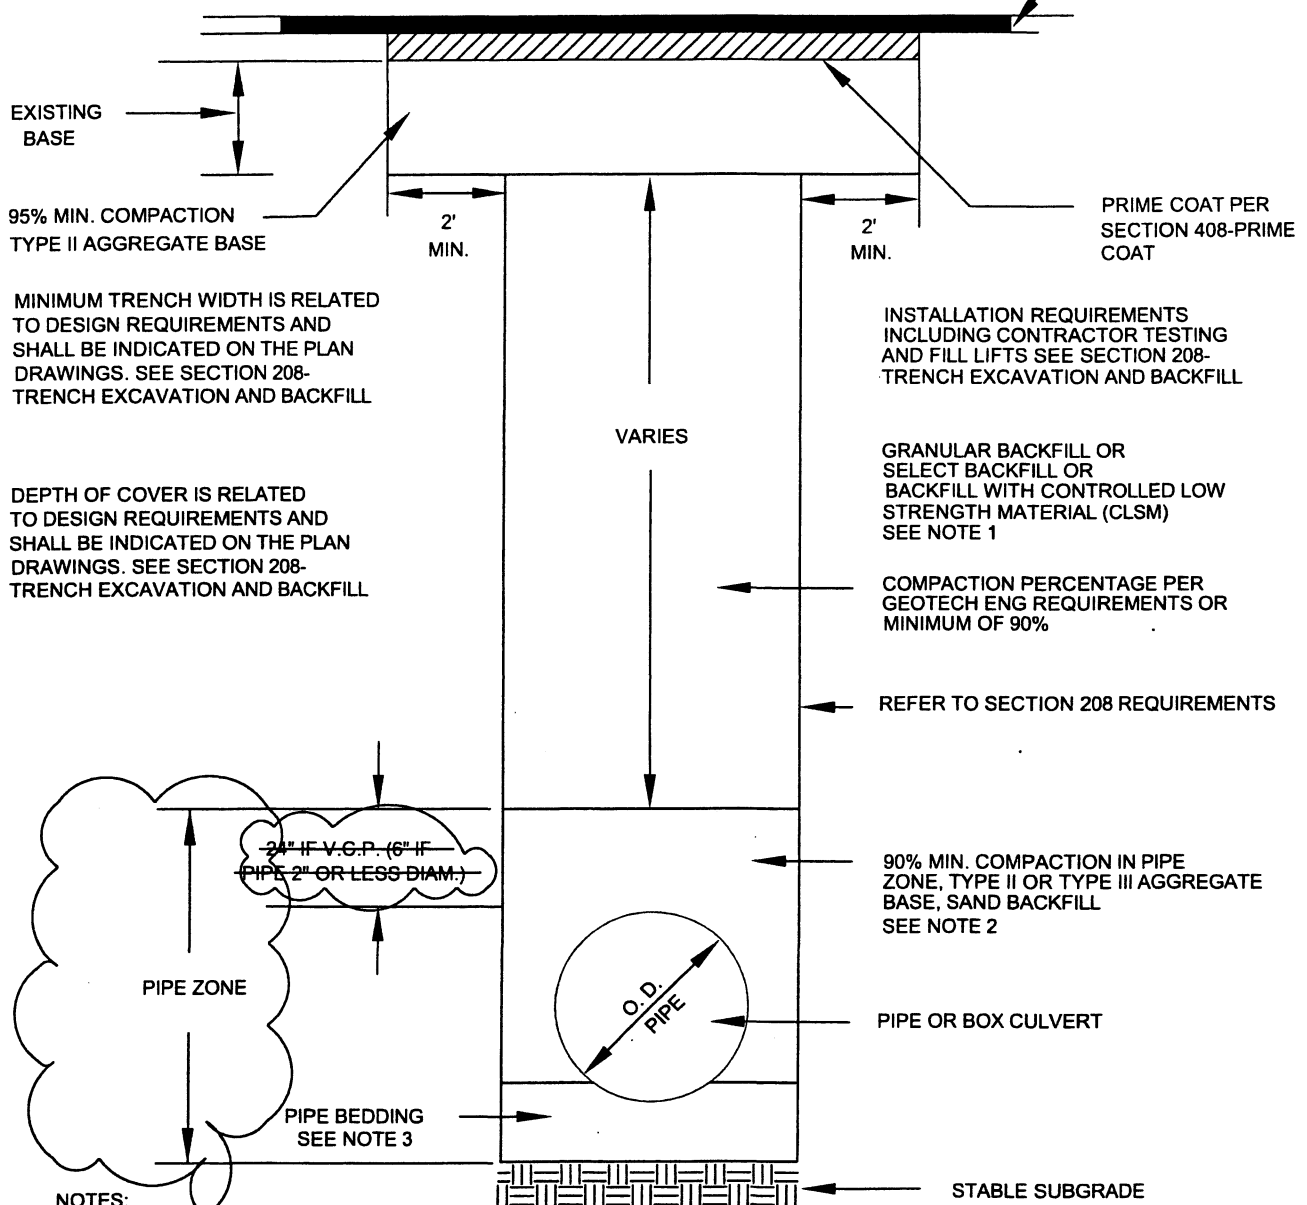

NOTES:

1. NO STONES OR LUMPS GREATER THAN 3" PERMITTED IN TRENCH 2' OR LESS IN WIDTH.
2. TRENCH WIDTH, BEDDING, SUBGRADE AND PIPE ZONE REQUIREMENTS FOR UTILITY INSTALLATIONS SHALL CONFORM TO THE RESPECTIVE ENTITY REQUIREMENTS.
3. CRUSHED ROCK MAY BE USED FOR PIPE BEDDING ONLY IF MATERIAL USE HAS BEEN SPECIFICALLY APPROVED BY THE GOVERNING AGENCY. SEE STANDARD DRAWING NO. 505 FOR PIPE BEDDING METHODS.
4. LAS VEGAS VALLEY WATER DISTRICT REQUIRES PIPE BEDDING AND BACKFILL WITHIN THE PIPE ZONE TO BE OF THE SAME MATERIAL.
5. A ONE INCH MAXIMUM LEVELING COURSE IS PERMITTED WHEN APPROVED BY THE ENGINEER.

SPECIFICATION REFERENCE		UNIFORM STANDARD DRAWINGS CLARK COUNTY AREA		
208	TRENCH EXCAVATION & BACKFILL			
302	AGGREGATE BASE COURSES	METHOD B FOR RIGID AND FLEXIBLE PIPE TRENCH BACKFILL - PAVED AREAS AND UNIMPROVED OR FUTURE PROPOSED STREET RIGHT OF WAY		
		DATE	DWG. NO. 503B	PAGE