


EFFECTIVE 07/01/09

RESTORATION LIMITS TO BE DETERMINED BY ENTITY PLAN CHECK, WITH FINAL LIMITS SET BY FIELD INSPECTOR.

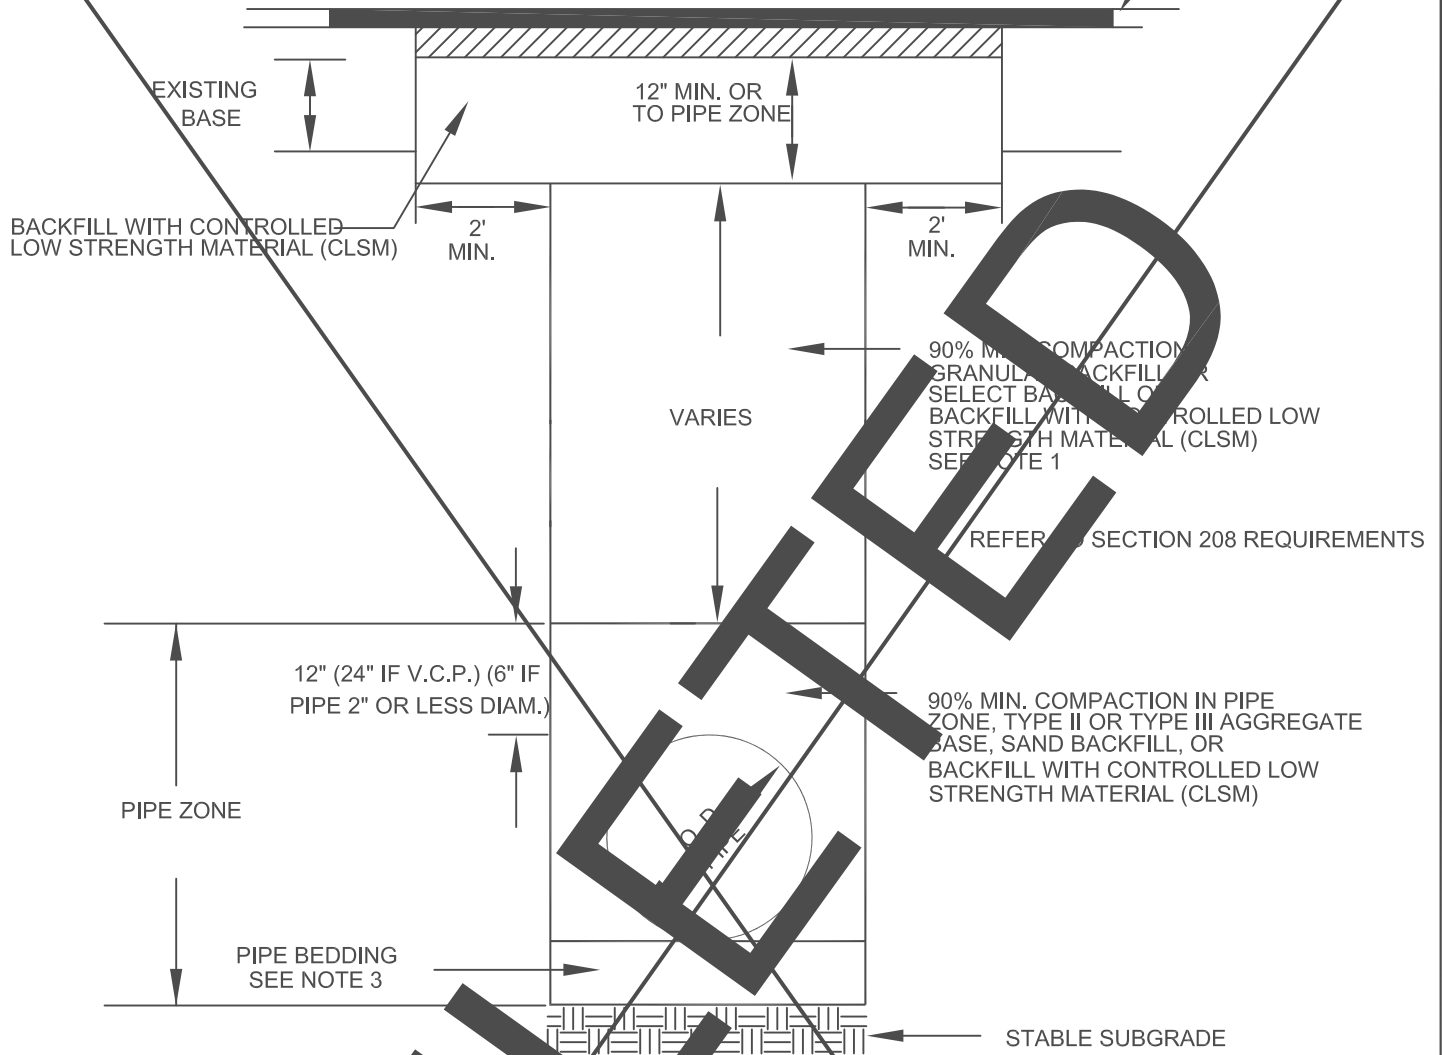

NOTES:

1. NO STONES OR LUMPS GREATER THAN 3" ARE PERMITTED IN TRENCH 2' OR LESS IN WIDTH.
2. IF SAWCUT IS WITHIN THREE FEET OF EDGE OF EXISTING ASPHALT CONCRETE SURFACE OR OTHER PATCH, REMOVE EXISTING PAVEMENT TO THAT EDGE AND REPLACE ENTIRE SECTION.
3. CRUSHED ROCK MATERIALS ARE PERMITTED FOR PIPE BEDDING ONLY IF MATERIAL USE HAS BEEN SPECIFICALLY APPROVED BY THE GOVERNING ENTITY. SEE STANDARD DRAWING NO. 505 FOR PIPE BEDDING MATERIALS.
4. LAS VEGAS SANITATION WATER DEPARTMENT REQUIRES PIPE BEDDING AND BACKFILL WITHIN THE PIPE ZONE TO BE OF THE SAME MATERIAL.

SPECIFICATION REFERENCE

UNIFORM STANDARD DRAWINGS
CLARK COUNTY AREA

208	TRENCH EXCAVATION & BACKFILL
302	AGGREGATE BASE COURSES

TRENCH BACKFILL WITH CONTROLLED
LOW STRENGTH MATERIAL (CLSM) ABOVE
PIPE ZONE IN PAVED AREAS
(STREETS GREATER THAN 60' R/W)

DATE 06-11-09 DWG. NO. 504