



ADDED LEFT TURN LANE

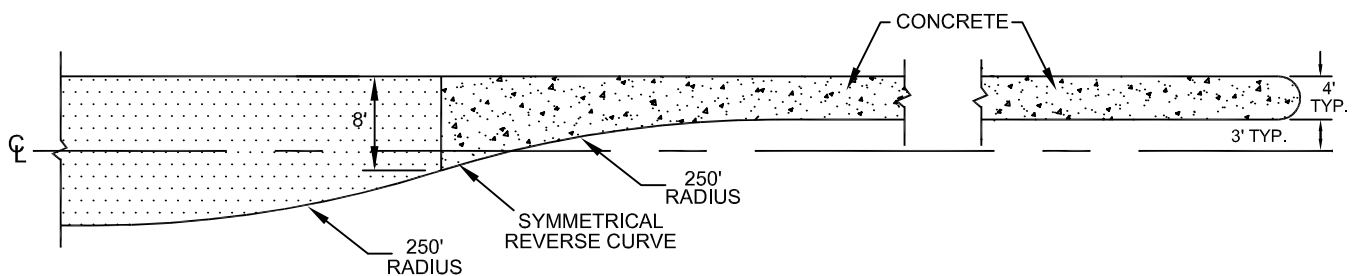

TYPICAL LEFT TURN MEDIAN DETAIL

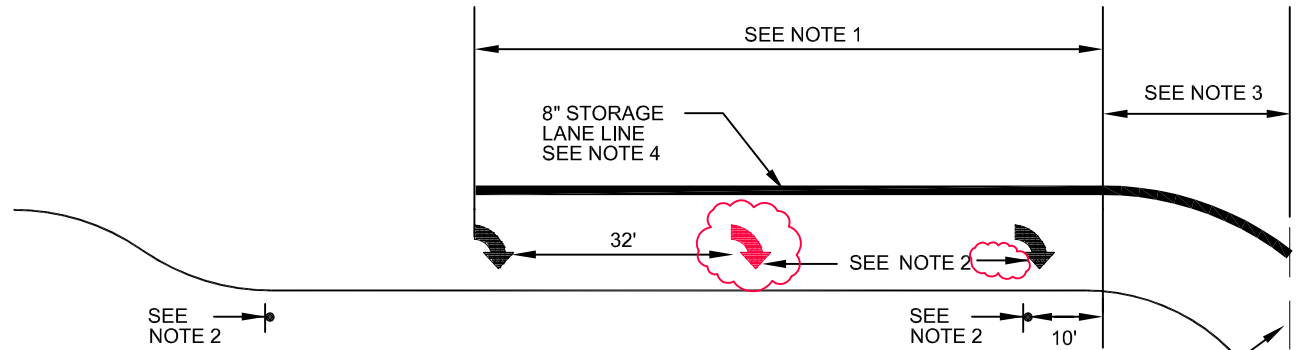

ADDED RIGHT TURN LANE

NOTES:

1. LENGTH OF STORAGE LINE IS TWO THIRDS OF THE ADDED TURN BAY. (MIN. 100')
2. WHERE ADDITIONAL MOTORIST GUIDANCE IS DEEMED NECESSARY BY THE ENGINEER, INSTALL R3-7R SIGNS AND ~~ARROW SYMBOL AND "ONLY" SYMBOL~~ PAVEMENT MARKINGS FOR THE LENGTH OF THE STORAGE LINE. SYMBOLS SHALL BE APPROVED TYPE II PAVEMENT MARKING FILM.
3. APPROVED TYPE II PAVEMENT MARKING FILM OR RAISED PAVEMENT MARKERS MAY BE USED FOR ADDITIONAL GUIDANCE AT THE DISCRETION OF THE ENGINEER.
4. STORAGE LANE LINE SHALL BE APPROVED TYPE I PAVEMENT MARKING FILM OR IF APPROVED BY THE ENGINEER, RAISED PAVEMENT MARKERS MAY BE USED.

		AGENCY APPROVED	B	C	H	L	M	N
SPECIFICATION REFERENCE		UNIFORM STANDARD DRAWINGS CLARK COUNTY AREA						
633	PAVEMENT MARKERS	STANDARD PAVEMENT MARKERS ADDED TURN LANE						
628	PAINTING TRAFFIC STRIPING, PAVEMENT MARKINGS...							
		DATE	12-08-09	DWG. NO.	246			